


LABOR AND MATERIALS

1 Copper } Connection 1" \$
 1 Lead }
 1 Curb } Cock } 2 in. \$
 } Valve }
 } T.S. & V. }
 1 Service box { Short 3 1/2 x 4 1/2 } Oriseal
 Old returned { Long 4 1/2 x 5 1/2 } Curb box.
 { Buff or Rdway } \$
 11 Ft. 2 in. { Copper } Pipe at \$
 } G.I. }
 } G.I. }
 Nipples in. at \$
 1 Bushings 1 1/4" to 2 Brass \$
 1 Red'g } 2 1/4" B' at 5' 1/2' Elbow \$
 1 Ine'g } Coupl'gs to in. at \$
 1 Union 2 in. at Male Adapter \$
 Meter in. at \$
 Lead Joints at \$
 Compound Joints at \$
 Maintenance Foreman \$
 Hrs. Water Maint. Man-1 at \$
 Hrs. Water Maint. Man-2 at \$
 Hrs. Garage Foreman at \$
 Hrs. Labor at \$
 Hrs. Compressor at \$
 Compensation Ins. at \$ per C. \$
 Trucking \$
 Pav't Patch \$
 Tap by Harreau & Co \$
 10-18-66 \$
 O'head \$
 \$

Marian
 St. _____
 Pl. _____
 Ave. No. 3

Name of Owner
 Temple-Beth-El.
 Labor and Mat'l. Report Oct. 18 1966

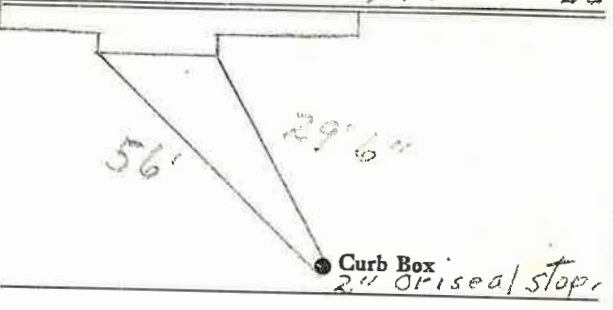

4" Main Elev. of Main at tap 5'

Gate at ● Gate at ●

TAX ID #302.20-7-6

● Curb Box