


LABOR AND MATERIALS

| | | | | | |
|----|-------------------------|---------------------|------------|----|-------|
| 1 | Copper Lead | Connection | 3/4" | \$ | 2.76 |
| 1 | Curb | Cock Valve | 3/4" in. | \$ | 3.49 |
| 1 | Service box | Short 3 1/2 X 4 1/2 | | | |
| | Old returned | Long 4 1/2 X 5 1/2 | | | |
| | | Buff or Rdway | | | 4.75 |
| 19 | Ft. | 3/4" in. Copper | | | |
| | | G.I. | Pipe at 35 | \$ | 6.65 |
| | | C.I. | | | |
| | Nipples | in. at | | \$ | |
| | Bushings | to in. at | | \$ | |
| | Red'g | | | \$ | |
| | Inc'g | Coupl'gs to in. at | | \$ | |
| | Union | in. at | | \$ | |
| | Meter | in. at | | \$ | |
| | Lead Joints | at | | \$ | |
| | Compound Joints | at | | \$ | |
| 2 | Hrs. Water Maint. Man-1 | at 1.24 | | \$ | 2.68 |
| 5 | Hrs. Water Maint. Man-2 | at 1.24 | | \$ | 6.20 |
| 6 | Hrs. Labor Man | at 1.44 | | \$ | 8.64 |
| 25 | Hrs. Labor | at 1.13 | | \$ | 28.25 |
| 2 | Hrs. Compressor | at 1.50 | | \$ | 3.00 |
| | Compensation Ins. | at \$7.06 per C | | \$ | 1.70 |
| | Trucking | | | \$ | 1.00 |
| | Pav't Patch | | | \$ | 14.96 |
| | O'head | | | \$ | |
| | Tap by Gifford | | | \$ | 84.08 |
| | 6-20-52 | | | | |

69.12

St
Pl
Marion Ave. No. 17
Name of Owner Heywood
Labor and Mat'l. Report June 20 19 52

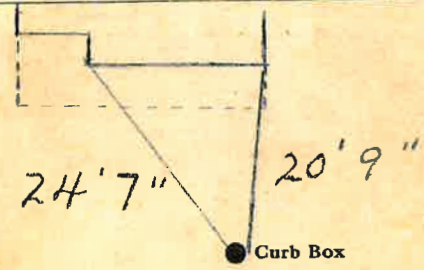

4" Main Elev. of Main at tap 5 1/2'
Gate at ● Gate at ●

TAX ID # 302.20-7-12

● Curb Box