

LABOR AND MATERIALS


1	Copper	} Connection	_____	\$	
	Lead				
	Curb	} Cock } Valve } T.S. & V.	_____ in.	\$	
1	Service box		} Short 3½ x 4½ } Long 4½ x 5½ } Buff or Rdway	_____	\$
	Old returned				
13	Ft. ³ / ₄ in.	} Copper } G.I. } C.I.		_____ Pipe at	\$
	Nipples	_____ in.	at _____	\$	
	Bushings	_____ to _____	in. at _____	\$	
	Red'g } Inc'g }	} Coupl'gs	_____ to _____	in. at _____	\$
	Union		_____ in.	at _____	\$
	Meter	_____ in.	at _____	\$	
	Lead Joints	_____ at _____		\$	
	Compound Joints	_____ at _____		\$	
	Maintenance Foreman	_____		\$	
	Hrs. Water Maint. Man—1	at _____		\$	
	Hrs. Water Maint. Man—2	at _____		\$	
	Hrs. Garage Foreman	_____ at _____		\$	
	Hrs. Labor—	_____ at _____		\$	
	Hrs. Compressor	at _____		\$	
	Compensation Ins. at \$	_____ per C		\$	
	Trucking	_____		\$	
	Pav't Patch	_____		\$	
				\$	
				\$	
	O'head	_____		\$	
				\$	

MARION

St. Pl. Ave. No. 9

Name of Owner
TAX ID #302.20-7-8

Labor and Mat'l. Report Sept. 5 1925

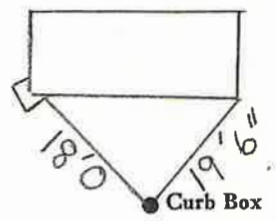

6" Main Elev. of Main at tap 5
Gate at ● ● Gate at

13' to main

3/4" copper ● Curb Box
Old tap to be dug up.