


**Labor and Materials**

1	Copper Lead	Connection	.....	\$ 3.20
1	Curb	{ Cock Valve T.S. & V. }	..... in. ....	\$ 1.00
1	Service Box Old returned	{ Short 3 1/2 x 4 Long 4 1/2 x 5 Buff. or Rdway }	.....	\$ 1.40
18	Ft. 3/4 in.	{ Copper Galv. Iron Cast Iron }	Pipe at.....	\$ 3.96
	Nipples	..... in. at.....		\$
	Bushings	..... to..... in. at.....		\$
	Red'g Inc'g	{ Couplings	..... to..... in. at.....	\$
	Union	..... in. at.....		\$
	Meter	..... in. at.....		\$
	Lbs. Br. Stone	at.....		\$
	Lbs. Sand	at.....		\$
	Bags Cement	at.....		\$
	Paving Brick	{ Mack Red Asphalt }	at.....	\$
	Lead Joints	at.....		\$
	Leadite Joints	at.....		\$
1	Hrs. Foreman	at.....	62.5	\$ 62.50
11	Hrs. Common Labor	at.....	50	\$ 50.00
8	Hrs. Common Labor	at.....	20.5	\$ 20.50
	Hrs. Mason	at.....		\$
	Hrs. Mason's Helper	at.....		\$
	Hrs. Compressor	at.....		\$
	Compensation Ins.	.....	28	\$ 28.00
	Trucking	.....	1.00	\$ 1.00
	Builders' Use of Water	.....		\$
Total				\$ 202.00

26-164

Labor and Material Report Nov J 19 26

Maximum Aug - 10  
TAP ON ACKLEY ST

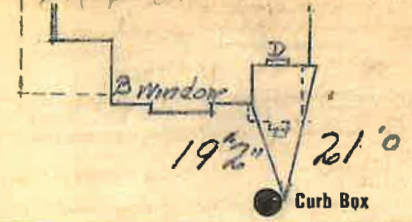

6 Main Elev. of Main at tap 5  
Gate at 18' to MAIN Gate at

3/4" Copper Curb Box

OLD TAP TO BE dug  
up Maxwain gulf

TAX ID #302.20-4-1

Measurements 10 Marion

For

Old Tap --- 1  
Marion Ave ---  
22-9

22-2

Old Buffalo box - no top and  
full of dirt.

