

Labor and Materials


+	Copper	Connection	3	\$ 2.70
+	Lead			
+	Curb	Cock Valve T.S. & V. } in.	3 1/2	\$ 2.39
+	Service Box	Short 3/4 x 4 1/2 } Long 4 1/2 x 5 1/2 } Buff. or Rdway }	1	\$ 1.45
+	2 Ft.	Copper Galv. Iron Cast Iron } Pipe at	3	\$ 3.51
	Nipples	in. at		\$
+	Bushings	to 1/2 in. at	1	\$.10
	Red'g Inc'g } Couplings	to in. at		\$
	Union	in. at		\$
	Meter	in. at		\$
	Lbs. Br. Stone	at		\$
	Lbs. Sand	at		\$
	Bags Cement	at		\$
	Paving Brick	Mack Red Asphalt } at		\$
	Lead Joints	at		\$
	Leadite Joints	at		\$
4	Hrs. Foreman	at		\$ 2.50
1.4	Hrs. Common Labor	at		\$ 6.30
	Hrs. Common Labor	at		\$
	Hrs. Mason	at		\$
	Hrs. Mason's Helper	at		\$
	Hrs. Compressor	at		\$
	Compensation Ins			\$ 2.7
	Trucking			\$ 1.00
	Builders' Use of Water	Patch.		\$ 5.00
Total \$				25.22

30-103

Labor and Material Report

Aug. 21 1930

11 Marion Court

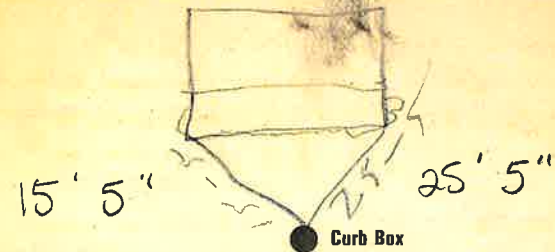

Galvanized iron main

3 Main Eley of Main at tap 5 1/2

Gate at 13' to main Gate at

3/4" copper Curb Box

Old Tap dismantled