


**Labor and Materials**

1	Copper } Connection.....	$\frac{3}{4}$	\$ 3.20
	Lead } .....	$\frac{1}{4}$	
1	Curb { Cock } .....	$\frac{3}{4}$	\$ 1.00
	{ Valve } .....	$\frac{3}{4}$	
	{ P. S. & V. } .....	$\frac{3}{4}$	
1	Service Box { Short 3 $\frac{1}{2}$ x 4 $\frac{1}{2}$ } .....		\$ 1.30
	Old returned { } .....		
	{ Bush or Redway } .....		
16	Ft. .... in. { Copper } Pipe at.....	$\frac{3}{4}$	\$ 3.52
	{ Cast Iron } .....		
	Nipples..... in. at.....		\$
1	Bushings..... to $\frac{1}{2}$ in. at.....		\$ .08
	Red'g } Couplings..... to..... in. at.....		\$
	Inc'g } .....		
	Union..... in. at.....		\$
	Meter..... in. at.....		\$
	Lbs. Br. Stone at.....		\$
	Lbs. Sand at.....		\$
	Bags Cement at.....		\$
	Paving Brick { Mack } at.....		\$
	{ Red } .....		
	{ Asphalt } .....		
	Lead Joints at.....		\$
	Leadite Joints at.....		\$
1.1	Hrs. Foreman at.....	$\frac{6.25}{20}$	\$ 6.88
8	Hrs. Common Labor at.....	$\frac{40.50}{20}$	\$ 2.25
	Hrs. Common Labor at.....		\$
	Hrs. Mason at.....		\$
	Hrs. Mason's Helper at.....		\$
	Hrs. Compressor at.....		\$
	Compensation Ins.....		\$ 2.7
	Trucking.....		\$ 1.00
	Builders' Use of Water.....		\$
Total			\$ 20.50

27-178 Labor and Material Report Oct 7 1927

12 Iron on Arm

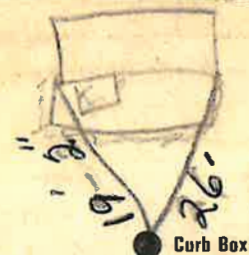

4 Main Elev. of Main at tap 5

Gate at ● Gate at ●

16' to MAIN

3/4" COPPER ● Curb Box

old shut off

TAX ID #302.20-4-17