

LABOR AND MATERIALS

1	Copper Lead	Connection	1/2" x 3/4"	\$	1.96
1	Curb	Cock Valve T.S. & V.	3/4 in.	\$	3.41
1	Service box	Short 3 1/2 x 4 1/2	}	\$	4.18
Old returned	Long 4 1/2 x 5 1/2				
17	Ft. 3/4 in.	Copper G.I. G.I.	Pipe at	40	\$ 6.80
	Nipples	in. at		\$	
	Bushings	to in. at		\$	
	Red'g Inc'g	Coupl'gs to in. at		\$	
	Union	in. at		\$	
	Meter	in. at		\$	
	Lead Joints	at		\$	
	Compound Joints	at		\$	
	Maintenance Foreman			\$	
	Hrs. Water Maint. Man-1	at		\$	
10	Hrs. Water Maint. Man-2	at 1.24		\$	12.40
	Hrs. Garage Foreman	at		\$	
26	Hrs. Labor	at 1.13		\$	29.38
	Hrs. Compressor	at		\$	
	Compensation Ins.	at \$ 2.861 per C		\$	1.61
	Trucking			\$	1.50
	Pav't Patch			\$	16.88
	Tap by Giggord	9-15-54		\$	
	O'head			\$	
				\$	78.12

6124


41.78

66-54

St. _____
Pl. _____
Ave. No. 13

Name of Owner
Heywood

Labor and Mat'l. Report Sept 15 1954

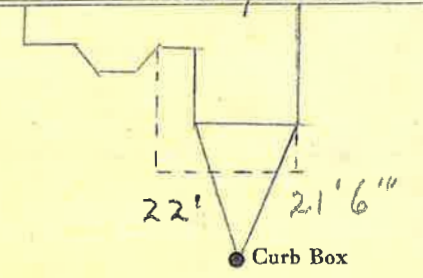

3" galv. Main Elev. of Main at tap 5'

Gate at • Gate at •

TAX ID #302.20-7-10

• Curb Box