


Labor and Materials

.. ...	Copper } Connection.....	$\frac{3}{4}$ "	\$ 1.25
.. ...	Lead } Curb { Cock Valve T.S.&V. }	$\frac{3}{4}$ " in	\$ 1.70
.. ...	Service Box Old returned	{ Short $2\frac{1}{2} \times 4\frac{1}{2}$ Long $4\frac{1}{2} \times 5\frac{1}{2}$ Bull. or Railway }	\$ 1.45
.. ...	Ft. $\frac{3}{4}$ " in. { Copper Galv. Iron Cast Iron } Pipe at	$12\frac{1}{2}$ "	\$ 1.49
.....	Nipples	in. at	\$
.....	Bushings	to	in. at
.....	Red'g Inc'g } Couplings.....	to	in. at
.....	Union.....	in. at	\$
.....	Meter.....	in. at	\$
.....	Lbs. Br. Stone at	\$
.....	Lbs. Sand at	\$
.....	Bags Cement at	\$
.....	Paving Brick { Mack Red Asphalt } at	\$
.....	Lead Joints at	\$
.....	Leadite Joints at	\$
.. A ..	Hrs. Foreman at	$6\frac{1}{2}$ hr.	\$ 2.50
.. A ..	Hrs. Common Labor at	45	\$ 1.80
.....	Hrs. Common Labor at	\$
.....	Hrs. Mason at	\$
.....	Hrs. Masons Helper at	\$
.....	Hrs. Compressor at	\$
.....	Compensation Ins	\$ 1.6
.....	Trucking	\$ 1-
.....	Bullders Use of Water	Patch	\$ 2.50

Total \$ 13.85

Labor and Material Report

3 Mason

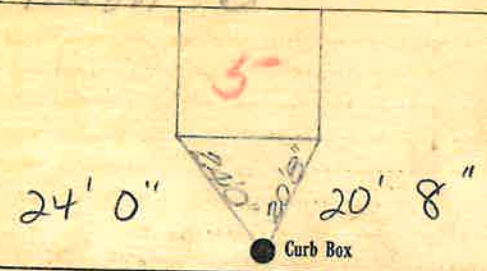

6 Main Elev. of Main at tap 5

Gate at • Gate at •

• Curb Box

New House

TH