


Labor and Materials

Lead Connection ^{3/4}	\$
Curb Cock ^{3/4}	\$
Service Box (Short 3 1/2 x 4 1/2 Old returned Long 4 1/2 x 6 1/2 Buffalo)	\$
20 Ft. in. C.L. Pipe at ^{3/4} COPPER	\$
Nipples.....in. at.....	\$
Bushings.....to.....in. at.....	\$
Red'g Coup...to...in. at.....	\$
Inc'g Coup...to...in. at.....	\$
Union...in. at.....	\$
Meter...in. at.....	\$
Cu. Yds. Br. Stone at.....	\$
Cu. Yds. Sand at.....	\$
Bags Cement at.....	\$
Paving Brick { Mack { Red { Asphalt } at.....	\$
2 Hrs. Foreman at.....	\$
13 Hrs. Common Labor at.....	\$
Hrs. Mason at.....	\$
Hrs. at.....	\$
Hrs. at.....	\$
Builders' Use of Water.....	\$
..... at.....	\$
..... at.....	\$
Total	\$16.30	

20 Aug. 1922
Labor and Material Report 3

16 Main Street

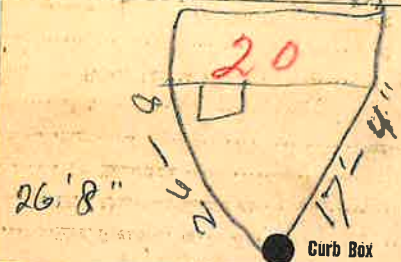

Main Elev. of Main at tap 5.2

Gate at ● Gate at ●

● Curb Box