

Labor and Materials


| | | | | |
|----------|-----------------------|---------------------|-----------|---------|
| 1 | Copper | Connection | 3 | \$ 1.33 |
| 1 | Lead | | 11 | |
| 1 | Curb | Cock | 3 | \$ 1.58 |
| | | Valve | 4 | |
| | | T.S. & V. | | |
| 1 | Service Box | Short 3 1/2 x 4 1/2 | | \$ 1.36 |
| | Old returned | Long 4 1/2 x 6 1/2 | | |
| | | Buff. or Red wax | | |
| 2 1/2 | Ft. | Copper | 3 | \$ 2.00 |
| | in. | Galv. Iron | 4 | |
| | | Cast Iron | | |
| | Nipples | in. at | | \$ |
| | Bushings | to in. at | | \$ |
| | Red'g | Couplings | to in. at | \$ |
| | Inc'g | | | \$ |
| | Union | in. at | | \$ |
| | Meter | in. at | | \$ |
| | Lbs. Br. Stone | at | | \$ |
| | Lbs. Sand | at | | \$ |
| | Bags Cement | at | | \$ |
| | Paving Brick | Mack | at | \$ |
| | | Red | | \$ |
| | | Asphalt | | \$ |
| | Lead Joints | at | | \$ |
| | Leadite Joints | at | | \$ |
| 12 | Hrs. Foreman | | | \$ 7.50 |
| 7 | Hrs. Common Labor | Tapper | | \$ 3.50 |
| | Hrs. Common Labor | | | \$ |
| | Hrs. Mason | | | \$ |
| | Hrs. Masons Helper | | | \$ |
| | Hrs. Compressor | | | \$ |
| | Compensation Ins | | | \$ 34 |
| | Trucking | | | \$ 1 |
| | Builders Use of Water | Patch | | \$ 5 |
| Total \$ | | | | 23.61 |

33-49

Labor and Material Report

July 17, 1933

20 Mason St

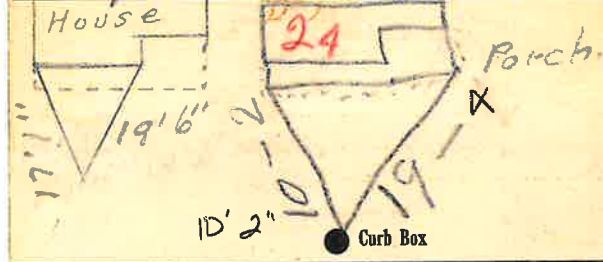

4" Main Elev. of Main at tap

Gate at ● Gate at ●

● Curb Box

Old trap disconnected

(Handwritten signature)

Tax ID # 302.12-16-18

711