

### Labor and Materials

1	Copper	{	Connection.....	\$ 1.23
	Lead	}		
1	Curb	{	Cock Valve } $\frac{3}{4}$ in.....	\$ 1.68
			F. S. & V. }	
1	Service Box	{	Short $3\frac{1}{2} \times 4\frac{1}{2}$ }	\$ 1.75
	Old-retained		Long $4\frac{1}{2} \times 5\frac{1}{2}$ }	
			Buff. or Rdway }	
20	Ft. $\frac{3}{4}$ in.	{	Copper	\$ 3.00
			Galv Iron	
			Cast Iron	
	Nipples		in. at.....	\$
	Bushings		to..... in. at.....	\$
	Red'g	{	Conplings..... to..... in. at.....	\$
	Inc'g	}		
	Union		in. at.....	\$
	Meter		in. at.....	\$
	Lead Joints		at.....	\$
	Leadite Joints		at.....	\$
	Hrs. Foreman		at.....	\$
3	Hrs. Chauffeur		at $62\frac{1}{2}$ .....	\$ 1.88
6	Hrs. Tapper		at.....	\$ 3.75
8	Hrs. Labor		at $45$ .....	\$ 3.60
	Hrs. Labor		at.....	\$
	Hrs. Compressor		at.....	\$
	Compensation Ins.		.....	\$ 28
	Trucking		.....	\$ 1.00
	Builders Use of Water		.....	\$
	Tap by Hessel		.....	\$
	Patch		.....	\$ 5.00
			.....	\$
			.....	\$
			.....	\$ 23.17

22 - 1938


St. **46**  
Pl.  
Ave. No. **42**

MASON

Name of Owner

B. Smith

Labor and Mat'l. Report 5-19-38 19

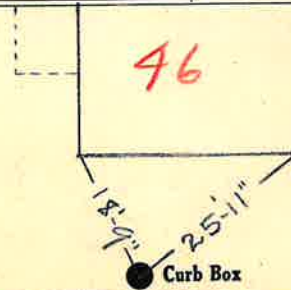

4" Main

Elev. of Main at tap..... 5

Gate at ●

● Gate at

● Curb Box

Tax Map # 302.12-16-29

old shut off at Mason St.