


Labor and Materials

..4..	Copper } Connection.....	\$ 1.75
..1..	Lead } ..	
..1..	Curb { Cock } ..in ..	\$ 1.70
	{ Valve } ..	
	{ P.S.V. } ..	
..1..	Service Box { Short <del>3 1/2</del> x 4 1/2 } ..	\$ 1.45
	{ Long 4 1/2 x 5 1/2 } ..	
	{ Buff. or Ridg. } ..	
..8..	Ft. 3/4 in. { Copper } Pipe at 12 1/2	\$ 1.08
	{ Galv. Iron } ..	
	{ Cast Iron } ..	
.....	Nipples ..in. at ..	\$ ..
.....	Bushings ..to ..in. at ..	\$ ..
.....	Red'g } Couplings.....to ..in.at ..	\$ ..
	{ Inc'g } ..	
.....	Union.....in. at ..	\$ ..
.....	Meter.....in. at ..	\$ ..
.....	Lbs. Br. Stone at ..	\$ ..
.....	Lbs. Sand at ..	\$ ..
.....	Bags Cement at ..	\$ ..
.....	Paving Brick { Mack } at ..	\$ ..
	{ Red } ..	
	{ Asphalt } ..	
.....	Lead Joints at ..	\$ ..
.....	Leadite Joints at ..	\$ ..
..7..	Hrs. Foreman at ..	\$ 1.75
..7..	Hrs. Common Labor at ..	\$ 1.25
..16..	Hrs. Common Labor at ..	\$ 7.20
.....	Hrs. Mason at ..	\$ ..
.....	Hrs. Masons Helper at ..	\$ ..
.....	Hrs. Compressor at ..	\$ ..
.....	Compensation Ins ..	\$ 36
.....	Trucking ..	\$ 1.00
.....	Builders Use of Water Patch ..	\$ 5.00
Total \$		21.29

1935 17  
 Labor and Material Report May 3 1935

5 Mason St.

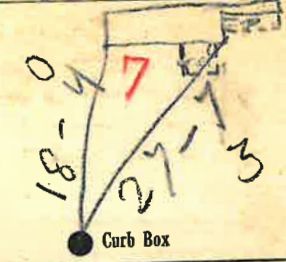

4 Main Elev of Main at tap 52  
 Gate at Gate at  
 TAX ID # 302.12-18-6

● Curb Box

Start off at main

*[Handwritten signature]*