

### LABOR AND MATERIALS

1	Copper Lead	} Connection	3/4		\$ 2.80
1	Curb	} Clock Valve (T. S. & V.)	3/4	in.	\$ 3.60
1	Service box Old returned	} Short 3 1/2 X 4 1/2 Long 4 1/2 X 5 1/2 Buff or Rdway			\$ 5.80
21 <del>18</del>	Ft.	} Copper Galv. Iron Cast Iron	3/4	in.	Pipe at \$ 6.30
	Nipples	in. at			\$
	Bushings	to in. at			\$
	Red'g Inc'g	} Couplings	to	in. at	\$
	Union	in. at			\$
	Meter	in. at			\$
	Lead Joints	at			\$
	Compound Joints	at			\$
7	Hrs. Foreman	at			\$ 2.02
2	Hrs. Chauffeur	at			\$ 1.82
	Hrs. Tapper	at			\$
15	Hrs. Labor	at			\$ 12.00
	Hrs. Labor	at			\$
	Hrs. Compressor	at			\$
	Compensation Ins.				\$ 35
	Trucking				\$ 1
	Builders Use of Water				\$
	Tap by Muller				\$
					\$
					\$
					\$ 35.69


55-47

St. \_\_\_\_\_  
 Pt. \_\_\_\_\_  
 Ave. No. 52

Mason

Name of Owner  
McCann

Labor and Mat'l. Report July 23 1947

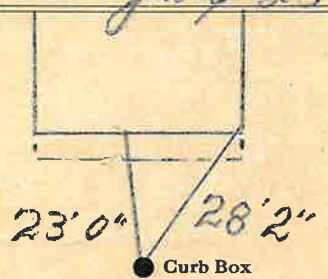

6"-1970

~~4~~ Main Elev. of Main at tap 4'

Gate at ● Gate at ●

● Curb Box

Tax map # 302.12-16-32