

LABOR AND MATERIALS


1	Copper Lead	Connection	3/4	\$	2.80	
1	Curb	Clock Valve F.S. & V.	3/4 in.	\$	3.60	
1	Service box Old returned	Short 3 1/2 X 4 1/2 Long 4 1/2 X 5 1/2 Buff or Rdway		\$	5.80	
20	17 Ft.	Copper Galv. Iron Cast Iron	3/4 in. Pipe at	\$	5.95	
	Nipples	in. at		\$		
	Bushings	to in. at		\$		
	Red'g Inc'g	Couplings	to in. at	\$		
	Union	in. at		\$		
	Meter	in. at		\$		
	Lead Joints	at		\$		
	Compound Joints	at		\$		
2	Hrs. Foreman	at		\$	2.02	
2	Hrs. Chauffeur	at		\$	1.82	
15	Hrs. Tapper	at		\$		
	Hrs. Labor	at		\$	12.00	
	Hrs. Labor	at		\$		
	Hrs. Compressor	at		\$		
	Compensation Ins.			\$	35	
	Trucking			\$	1.00	
	Builders Use of Water			\$		
	Tap by Marsinske				\$	
					\$	
					\$	
					\$	35.34

61-47

St.
 Pt.
 Ave. No. 54

Name of Owner
 Denton

Labor and Mat'l. Report July 22 1947

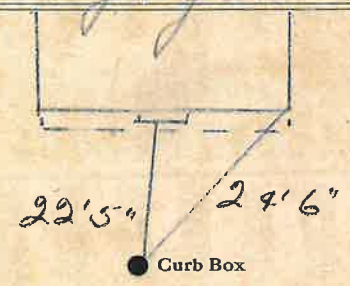

6"-1970
 Main Elev. of Main at tap
 Gate at Gate at

Curb Box

Tax Map # 302.12-16-33