


Labor and Materials

Copper } Connection.....	$\frac{3}{4}$	\$ 1.48
Lead } Connection.....	$\frac{3}{4}$	\$ 1.79
Curb { Cock Valve T.S. ev. }	3	\$ 1.79
Service Box { Short $3\frac{1}{2} \times 4\frac{1}{2}$ Long $4\frac{1}{2} \times 6\frac{1}{2}$ Buff. or Rdwar. }	1	\$ 1.18
19 Ft. tn. { Copper Galv. Iron Cast Iron } Pipe at	2	\$ 3.42
Nipples	in. at	\$
Bushings	to	in. at
Red'g } Couplings.....	to	in. at
Inc'g } Couplings.....	to	in. at
Union.....	in. at	\$
Meter.....	in. at	\$
Lbs. Br. Stone at		\$
Lbs. Sand at		\$
Bags Cement at		\$
Paving Brick { Mack Red Asphalt } at		\$
Lead Joints at		\$
Leadite Joints at		\$
7 Hrs. Foreman at		\$ 1.25
17 Hrs. Common Labor at	45	\$ 5.40
Hrs. Common Labor at		\$
Hrs. Mason at		\$
Hrs. Masons Helper at		\$
Hrs. Compressor at		\$
Compensation Ins		\$ 2.1
Trucking		\$
Builders Use of Water	Part	\$ 5.00
Total \$		20.73

5 32-35 8
 Labor and Material Report May 3 1932

4 Mason St

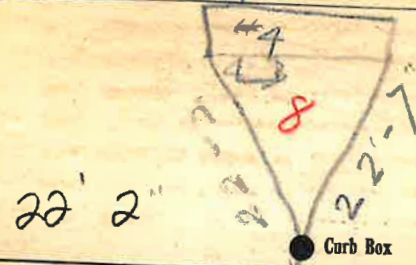

4 Main Elev. of Main at tap 52
 Gate at TAX ID # 302.12-16-10 Gate at

● Curb Box
 old tap shut off at Main

OK JTS