


Labor and Materials

Copper } Connection.....	3	\$. 96
Lead }	4	
Curb { Cock Valve }	1	\$. 33
{ T.S.&V. }	1	
Service Box { Short 2 1/2 x 4 1/2 }		\$. 35
Old returned { Long 4 1/2 x 5 1/2 }		
{ Buff. or Redway }		
9... Ft. 3/4 in. { Copper } Pipe at 15		\$. 1.20
{ Galv. Iron }		
{ Cast Iron }		
Nipples in. at		\$
Bushings to in. at		\$
Red'g } Couplings..... to..... in. at		\$
Inc'g }		
Union..... in. at		\$
Meter..... in. at		\$
Lbs. Br. Stone at		\$
Lbs. Sand at		\$
Bags Cement at		\$
Paving Brick { Mack } at		\$
{ Red }		
{ Asphalt }		
Lead Joints at		\$
Leadite Joints at		\$
5 Hrs. Foreman at <i>6.16</i>		\$. 31.80
4 Hrs. Common Labor at <i>5.00</i>		\$. 20.00
8 Hrs. Common Labor at <i>4.50</i>		\$. 36.00
Hrs. Mason at		\$
Hrs. Masons Helper at		\$
Hrs. Compressor at		\$
Compensation Ins		\$. 29
Trucking		\$. 1.00
Builders Use of Water <i>with</i>		\$. 5.00
Total		\$ 19.84

83-76 9 9 10 1936
Labor and Material Report

79 Mason St

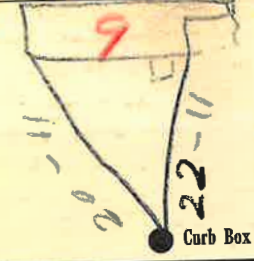

4 Main Elev of Main at tap *5 1/2*

Gate at ● ● Gate at

● Curb Box
old top shut off

TAX ID # 302.12-18-5

~~11~~