

LABOR AND MATERIALS


1	Copper } Connection	3/4	\$	2.80
1	Lead } Clock Valve T. S. & V.	3/4 in.	\$	3.60
1	Service box Old returned }	Short 3" X 4" Long 4" X 5" Buff or Rdway	\$	5.40
10 Ft.	3/4 in. } Copper Galv. Iron Cast Iron	Pipe at	\$	3.50
	Nipples	in. at	\$	
	Bushings	to in. at	\$	
	Red'g } Inc'g	Couplings to in. at	\$	
	Union	in. at	\$	
	Meter	in. at	\$	
	Lead Joints	at	\$	
	Compound Joints	at	\$	
2	Hrs. Foreman	at	\$	2.02
1	Hrs. Chauffeur	at	\$	91
	Hrs. Tapper	at	\$	
13	Hrs. Labor	80	\$	10.40
	Hrs. Labor	at	\$	
	Hrs. Compressor	at	\$	
	Compensation Ins.		\$	1.29
	Trucking		\$	<u>1.39</u>
	Builders Use of Water		\$	
	Taylor Miller		\$	
			\$	
			\$	
			\$	30.32

59-47

St. Mason
Pl. Ave. No. 11

Name of Owner
Nichols

Labor and Mat'l. Report July 26 1947

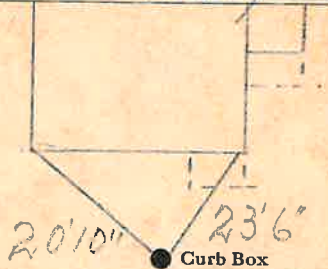

4 Main Elev. of Main at tap 4 1/2
Gate at ● Gate at ●

● Curb Box