


LABOR AND MATERIALS

1	Copper Lead	Connection	$\frac{3}{4}$	\$	2.80
1	Curb	Clock Valve T.S. & V.	$\frac{3}{4}$ in.	\$	3.60
1	Service box Old returned	Short $3\frac{1}{2} \times 4\frac{1}{2}$ Long $4\frac{1}{2} \times 5\frac{1}{2}$ Buff or Rdway		\$	5.80
8	Ft. $\frac{3}{4}$ in.	Copper Galv. Iron Cast-Iron	Pipe at $35$	\$	2.80
	Nipples	in. at		\$	
	Bushings	to in. at		\$	
	Red'g Inc'g	Couplings	to in. at	\$	
	Union	in. at		\$	
	Meter	in. at		\$	
	Lead Joints	at		\$	
	Compound Joints	at		\$	
2	Hrs. Foreman at		1.02	\$	2.02
1	Hrs. Chauffeur at		91	\$	91.00
	Hrs. Tapper at			\$	
13	Hrs. Labor at		80	\$	10.40
	Hrs. Labor at			\$	
	Hrs. Compressor at			\$	
	Compensation Ins.			\$	29
	Trucking			\$	1.29
	Builders Use of Water			\$	
	Tap by Miller			\$	
				\$	
				\$	
				\$	29.62

75 + 47

St. \_\_\_\_\_  
 Pl. \_\_\_\_\_  
 Ave. No. 13  
 Name of Owner \_\_\_\_\_  
 Mrs. Grant

Labor and Mat'l. Report July 28 1947

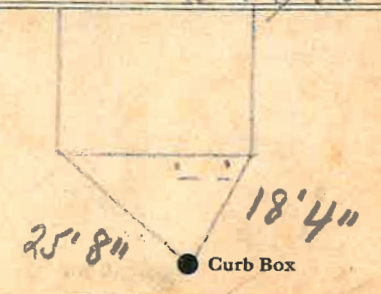

4 Main Elev. of Main at tap 41  
 Gate at ● Gate at ●

TAX ID # 302.12-18-3

● Curb Box