

LABOR AND MATERIALS

1	Copper Lead	{ Connection	3/4"	\$	2.27
1	Curb	{ Cock Valve T.S. & V.	3/4" in.	\$	2.70
1	Service box Old returned	{ Short 3 1/2 x 4 1/2 Long 4 1/2 x 5 1/2 Buff. or Rdway		\$	4.25
25	Ft. 3/4 in.	{ Copper C.T. C.T.	Pipe at 35	\$	8.75
	Nipples	in. at		\$	
	Bushings	to in. at		\$	
	Red'g Inc'g	{ Coupl'gs	to in. at	\$	
	Union	in. at		\$	
	Meter	in. at		\$	
	Lead Joints	at		\$	
	Compound Joints	at		\$	
	Hrs. Water Maint. Man-1	at		\$	
2	Hrs. Water Maint. Man-2	at 1.02		\$	2.04
12	Hrs. Labor	at 91		\$	10.92
	Hrs. Labor	at		\$	
	Hrs. Compressor	at		\$	
	Compensation Ins.	at \$ 2.226 per C.		\$	29
	Trucking			\$	1.00
	Pav't Patch	EFT. of Main		\$	
	Tap by Moquin			\$	
	O'head			\$	
				\$	37.22


New.

2.18-1950

Mauro St. 4 PT. 8 Ave. No. 8

Name of Owner Alfred Cusimano

Labor and Mat'l. Report Oct 27 19 50

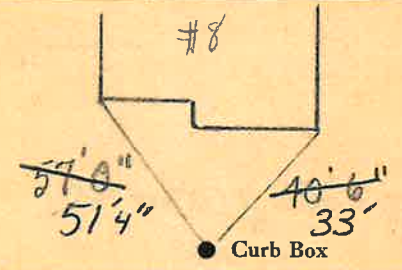

12" Main Elev. of Main at tap 5'

Gate at • Gate at Tax map # 303.9-11-1

CORRECTION • Curb Box ON MEASUREMENTS 10/2/2002