

LABOR AND MATERIALS

Copper	} Connection	_____	\$	
Lead				
Curb	} Cock	} _____ in.	\$	
	Valve			
	T. S. & V.			
Service box	} Short 3½ x 4½	} _____	\$	
Old returned				Long 4½ x 5½
				Buff or Rdway
28 Ft. ¾ in.	} Copper	} Pipe at	\$	
				C.I.
				C.I.
Nipples	in. at	_____	\$	
Bushings	to _____ in.	at	\$	
Red'g	} Coupl'gs	to _____ in.	at	\$
Inc'g				
Union	in. at	_____	\$	
Meter	in. at	_____	\$	
Lead Joints	at	_____	\$	
Compound Joints	at	_____	\$	
Maintenance Foreman		_____	\$	
Hrs. Water Maint. Man-1	at	_____	\$	
Hrs. Water Maint. Man-2	at	_____	\$	
Hrs. Garage Foreman	at	_____	\$	
Hrs. Labor	at	_____	\$	
Hrs. Compressor	at	_____	\$	
Compensation Ins.	at \$ _____ per C	_____	\$	
Trucking		_____	\$	
Pav't Patch		_____	\$	
		_____	\$	
		_____	\$	
O'head		_____	\$	

Mauro


St. _____
 Pt. _____
 Ave. No. 6

Name of Owner

Reed

Labor and Mat'l. Report

19 86

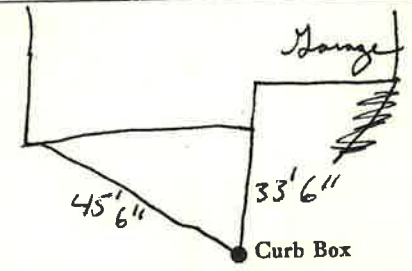

Main

Elev. of
Main at tap

Gate at ●

● Gate at

● Curb Box

Tax Map # 303.9-11-3