

LABOR AND MATERIALS

1	Copper Lead	Connection	3/4"	\$	2.41
1	Curb	Cock Valve T.S. & V.	3/4 in.	\$	3.41
1	Service box	Short 3 1/2 x 4 1/2		\$	4.18
	Old returned	Long 4 1/2 x 5 1/2		\$	
		Buff or Rdway		\$	
12	Ft. 3/4 in.	Copper G.I. G.I.	Pipe at 40	\$	4.80
	Nipples	in. at		\$	
	Bushings	to in. at		\$	
	Red'g			\$	
	Inc'g	Coupl'gs to in. at		\$	
	Union	in. at		\$	
	Meter	in. at		\$	
	Lead Joints	at		\$	
	Compound Joints	at		\$	
	Maintenance Foreman			\$	
	Hrs. Water Maint. Man-1	at		\$	
3	Hrs. Water Maint. Man-2	at		\$	3.72
	Hrs. Garage Foreman	at		\$	
10	Hrs. Labor	at 113		\$	11.30
	Hrs. Compressor	at		\$	
	Compensation Ins. at \$3.861 per C			\$	5.8
	Trucking			\$	1.50
	Pav't Patch			\$	10.80
	Tap by Giggard			\$	
	9-2-54			\$	
	O'head			\$	
				\$	42.70


3190

45-54

St. Mauvo
Pl. 7
Ave. No. 7

Name of Owner Hay

Labor and Mat'l. Report Aug. 2 19 54

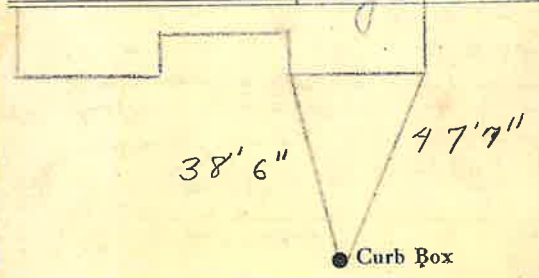

12" Main Elev. of Main at tap 4 1/2'

Gate at • Gate at

• Curb Box
Tax map # 303.9-7-29