


LABOR AND MATERIALS

1	Copper Lead	Connection	3/4"	\$	2.71
1	Curb	Cock Valve T. S. & V.	3/4 in.	\$	3.83
1	Service box	Short 3 1/2 x 4 1/2		\$	4.69
	Old returned	Long 4 1/2 x 5 1/2		\$	
		Buff or Rdway		\$	
27	Ft.	Copper G.I. Pipe at	3/4 in.	\$	12.15
	Nipples	in. at		\$	
	Bushings	to in. at		\$	
	Red'g	Coupl'gs	to in. at	\$	
	Inc'g				
	Union	in. at		\$	
	Meter	in. at		\$	
	Lead Joints	at		\$	
	Compound Joints	at		\$	
	Maintenance Foreman			\$	
	Hrs. Water Maint. Man	1 at		\$	
	Hrs. Water Maint. Man	2 at		\$	
2	Hrs. Garage Foreman	at	1.59	\$	3.18
	Hrs. Labor	at		\$	
	Hrs. Compressor	at		\$	
	Compensation Ins.	at \$	4.29 per C	\$	14
	Trucking			\$	1.50
	Pay't Patch			\$	
	Tap by Bureau		5-3-55	\$	
	O'head			\$	
				\$	28.70

Mauro  
~~JACKSON~~ St. 10  
 Ave. No. 29

Name of Owner  
 F. Hay

Labor and Mat'l. Report May 3 19 55

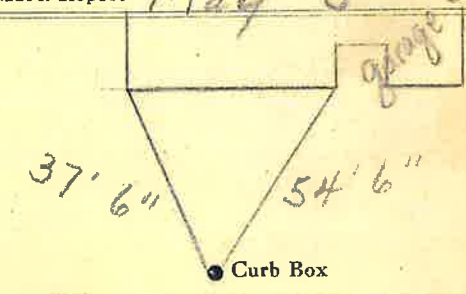

Mauro Ave.  
 12" Main Elev. of Main at tap 4

Gate at • Gate at  
 Tax Map # 303.9-11-4

• Curb Box  
 Tap on Mauro Ave.  
 New Copper line - June '90  
 - also new curb stop