


Labor and Materials

| | | | | |
|-----------------------|--|------|----|---------|
| Copper | } Connection..... | 3 | . | 1.50 |
| Lead | | | | |
| Curb | } Cock Valve 1.5" x 1.5" } | 3 | in | .170 |
| | | | | |
| Service Box | } Short 3" x 4 1/2" Long 4 1/2" x 5 1/2" Full or Rdway } | | | .154 |
| Old returned | | | | |
| 9 Ft. 3/4 in. | } Copper Galv. Iron Cast Iron } Pipe at | | | .171 |
| | | | | |
| Nipples | in. at | | | \$. |
| Bushings |to.....in. at..... | | | \$. |
| Red'g Inc'g | } Couplings.....to.....in.at..... | | | \$. |
| | | | | |
| Union |in. at | | | \$. |
| Meter |in. at | | | \$. |
| Lbs. Br. Stone | at | | | \$. |
| Lbs. Sand | at | | | \$. |
| Bags Cement | at | | | \$. |
| Paving Brick | } Mack Red Asphalt } at | | | \$. |
| Lead Joints | | | | |
| Leadite Joints | at | | | \$. |
| 3 Hrs. Foreman | at | 6.25 | | 1.88 |
| 4 Hrs. Common Labor | at | 50 | | 2.00 |
| 4 Hrs. Common Labor | at | 45 | | 1.80 |
| Hrs. Mason | at | | | \$. |
| Hrs. Masons Helper | at | | | \$. |
| Hrs. Compressor | at | | | \$. |
| Compensation Ins | | | | 2.20 |
| Trucking | | | | 1.50 |
| Builders Use of Water | Part Patch..... | | | 2.50 |
| Total | | | | \$15.83 |

25 34 13 15
Labor and Material Report

31 39
19

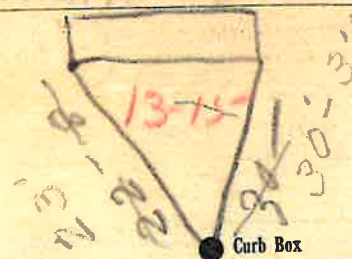

4 Main

Elev. of Main at tap 4 1/2

Gate at ●

● Gate at

● Curb Box

New Tap

Glens Falls
Distributing Co.

(13-15)

TAX Map ID# 302.20-18-9