

LABOR AND MATERIALS


1 Copper } Connection 1/2 \$
 Lead }
 1 Curb { Cock Valve } 5/8 in. \$
 T-S. & V. }
 1 Service Box { Short 3 1/2 x 4 1/2 } \$
 Old returned { Long 4 1/2 x 5 1/2 } \$
 4' 1" Ft. in. { Buff. or Rdway }
 { Copper } Pipe at \$
 { Galv Iron }
 { Cast Iron }
 Nipples in. at \$
 Bushings to in. at \$
 Red'g } Couplings to in. at \$
 Inc'g }
 Union in. at \$
 Meter in. at \$
 Lead Joints at \$
 Leadite Joints at \$
 Hrs. Foreman at \$
 Hrs. Chauffeur at \$
 Hrs. Tapper at \$
 Hrs. Labor at \$
 Hrs. Labor at \$
 Hrs. Compressor at \$
 Compensation Ins. \$
 Trucking \$
 Builders Use of Water \$
 \$
 \$
St. 20
 Pt. 14
 Ave. No. 14

MAY

Name of Owner

Labor and Mat'l. Report July 2 1918

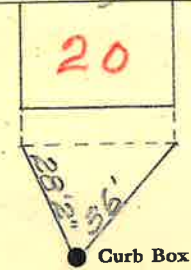

8" 1976

1" Gal. Main

Elev. of Main at tap

Gate at ●

● Gate at

● Curb Box

Tax Map # 302.20-10-21

Renewal Tap
 Fall 1986