


Labor and Materials

..+..	Copper } Connection.....	\$	96
..+..	Lead } .....	\$	
..+..	Curb { Cock } .....	\$	1.33
	{ Valve } .....		
	{ U.S. & V. } .....		
..1..	Service Box { Short 3 1/2 x 4 1/2 } .....	\$	1.35
	Old returned { Long 4 1/2 x 6 1/2 } .....		
	{ Buff. or Rdway } .....		
24'-8"	3/4" in. { Copper } Pipe at 15 .....	\$	355
	{ Cast Iron } .....		
.....	Nipples ..... in. at .....	\$	
.....	Bushings ..... to ..... in. at .....	\$	
.....	Red'g } Couplings ..... to ..... in. at .....	\$	
.....	Inc'g } .....		
.....	Union..... in. at .....	\$	
.....	Meter..... in. at .....	\$	
.....	Lbs. Br. Stone at .....	\$	
.....	Lbs. Sand at .....	\$	
.....	Bags Cement at .....	\$	
.....	Paving Brick { Mack } at .....	\$	
	{ Red } .....		
	{ Asphalt } .....		
.....	Lead Joints at .....	\$	
.....	Leadite Joints at .....	\$	
3	Hrs. Foreman at 6 1/2 hr	\$	1.88
16	Hrs. Common Labor at 45	\$	7.20
.....	Hrs. Common Labor at .....	\$	
.....	Hrs. Mason at .....	\$	
.....	Hrs. Masons Helper at .....	\$	
.....	Hrs. Compressor at .....	\$	
.....	Compensation Ins .....	\$	28
.....	Trucking .....	\$	1.00
.....	Builders Use of Water Patch	\$	5.00
Total \$			22.55

72 21-23

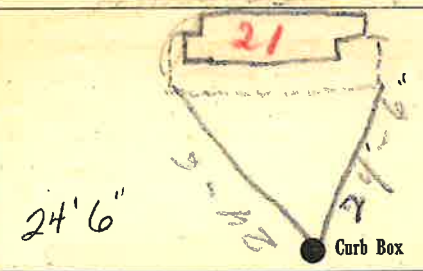

8" - 1946  
Main

Elev. of Main at tap 5

Gate at ● Gate at ●

● Curb Box

old shut off at main

#23  
Tax map # 302.20-18-6