

Labor and Materials


1	Copper } Connection. ^{3/4}	\$ 96
	Lead	
1	Curb { Cock Valve } ^{3/4} in	\$ 1.33
	T.S.&V.	
1	Service Box { Short 3 1/2 x 4 1/2 } Old returned { Long 4 1/2 x 5 1/2 } Buff. or Rdway	\$ 1.35
8'6" ^{3/4}	8'6" ^{3/4} in. { Copper } Pipe at 15	\$ 1.65
	Cast Iron	
	Nipples in. at	\$
	Bushings to in. at	\$
	Red'g } Couplings..... to in. at	\$
	Inc'g }	
	Union..... in. at	\$
	Meter..... in. at	\$
	Lbs. Br. Stone at	\$
	Lbs. Sand at	\$
	Bags Cement at	\$
	Paving Brick { Mack } at	\$
	Lead Joints at	\$
	Leadite Joints at	\$
	Hrs. Foreman at	\$
	Hrs. Common Labor at	\$
	Hrs. Common Labor at	\$
	Hrs. Mason at	\$
	Hrs. Masons Helper at	\$
	Hrs. Compressor at	\$
	Compensation Ins	\$
	Trucking	\$
	Builders Use of Water	\$
	Total \$.....	

Labor and Material Report

22

9-26-1976

May 11 16 22

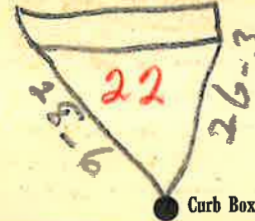

8" 1976
4 Main

Elev of Main at tap 5

Gate at TAX ID # 302.20-10-22 Gate at

Curb Box

Old tap dice

[Handwritten signature]