


Labor and Materials

1	Copper	Connection	9/4	96
	Lead			
1	Curb	Cock Valve	3/4 in	1.33
		D.S.&V		
1	Service Box	Short 3 1/2 x 4 1/2		1.35
	Old returned	Long 4 1/2 x 5 1/2		
		Bull. or Rdway		
20	2 1/4 Ft.	Copper Galv. Iron Cast Iron	Pipe at 15	3.00
	Nipples	in. at		
	Bushings	to in. at		
	Red'g Inc'g	Couplings	to in. at	
	Union	in. at		
	Meter	in. at		
	Lbs. Br. Stone	at		
	Lbs. Sand	at		
	Bags Cement	at		
	Paving Brick	Mack Red Asphalt	at	
	Lead Joints	at		
	Leadite Joints	at		
	Hrs. Foreman	at		
	Hrs. Common Labor	at		
	Hrs. Common Labor	at		
	Hrs. Mason	at		
	Hrs. Masons Helper	at		
	Hrs. Compressor	at		
	Compensation Ins			
	Trucking			
	Builders Use of Water			
Total \$				

121 May 4
 Labor and Material Report 9-23-1936

3, May St.

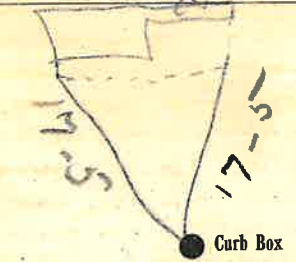

8" 1976
 X Main

Elev of Main at tap 5

Gate at ● Gate at ●

● Curb Box

Old tap Dive

[Handwritten signature]