

LABOR AND MATERIALS


1	Copper	} Connection	3/4"	\$	
1	Lead				
1	Curb	} Cock	3/4 in. Oriseal.	\$	
					} Valve
1	Service box	} { Short 3 1/2 x 4 1/2 Long 4 1/2 x 5 1/2 Buff or Rdway }		\$	
	Old returned				
28	3/4 in.				} { Copper C.I. C.I. }
	Nipples	in. at		\$	
	Bushings	to in. at		\$	
	Red'g	} Coupl'gs	to in. at	\$	
	Inc'g				
	Union	in. at		\$	
	Meter	in. at		\$	
	Lead Joints	at		\$	
	Compound Joints	at		\$	
	Maintenance Foreman			\$	
	Hrs. Water Maint. Man	1 at		\$	
	Hrs. Water Maint. Man	2 at		\$	
	Hrs. Garage Foreman	at		\$	
	Hrs. Labor	at		\$	
	Hrs. Compressor	at		\$	
	Compensation Ins.	at \$ per C		\$	
	Trucking			\$	
	Pav't Patch			\$	
	Tap by Gifford & Co			\$	
	7-29-68.			\$	
	O'head			\$	
				\$	

St. _____
 -Pl- _____
 Ave. No. 25

May

Name of Owner
 Dr. Lucia

Labor and Mat'l. Report July 29 1968

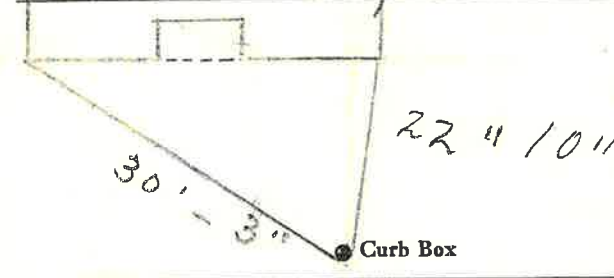

8"-1976
 Main Elev. of Main at tap 5'

Gate at • Gate at

• Curb Box

Tax Map # 302.20-18.5