


LABOR AND MATERIALS

1	Copper	{ Connection	3/4		\$ 2.29
	Lead				
1	Curb	{ Cock Valve F.S. & V.	3/4	in.	\$ 2.70
1	Service box	Short 3 1/2 x 4 1/2 Long 4 1/2 x 5 1/2 Buff or Rdway			\$ 4.25
	Old returned				
6'-8"	Ft.	Copper	3	in.	\$ 3.85
				Pipe at 35	
	Nipples	in. at			\$
	Bushings	to in. at			\$
	Red'g	{ Coupl'gs to in. at			\$
	Inc'g				\$
	Union	in. at			\$
	Meter	in. at			\$
	Lead Joints at				\$
	Compound Joints at				\$
1/6	Hrs. Water Maint. Man-1	at	1.12		\$ 6.12
6	Hrs. Water Maint. Man-2	at	1.07		\$ 6.37
7	Hrs. Labor	at	.91		\$ 6.37
	Hrs. Labor	at			\$
2	Hrs. Compressor at		1.20		\$ 2.40
	Compensation Ins. at \$	per C.			\$ 31
	Trucking				\$ 14.18
	Pav't Patch				\$
	<i>Top by Miller</i>				\$
	O'head				\$ 44.59

St.
Pl.
Ave. No 26-28

Name of Owner Whiting

Labor and Mat'l. Report Apr 11 1950

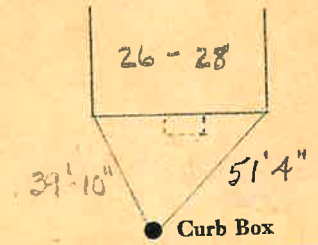

8"-1976
4 5/8 Main

Elev. of Main at tap 5-

Gate at ● ● Gate at

● Curb Box

Tax map # 302.20-10-23