

MAY


St. Pl. Ave. No. 29

Name of Owner

Labor and Mat'l. Report

1/13/15

OUTSIDE CLEAN OUT

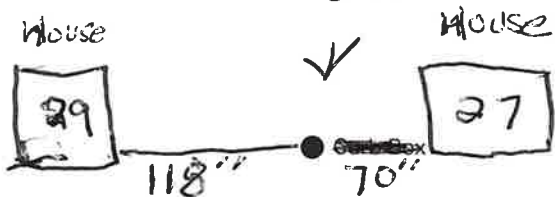

Main

Elev. of Main at tap

Gate at ●

● Gate at

● Curb Box


Labor and Material Report

June

3

1920

19 Main St. 29

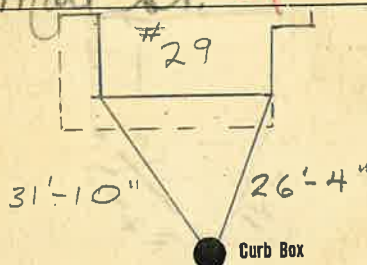

8"-1976

Main

Elev. of Main at tap 6'

Gate at ●

● Gate at

● Curb Box

Remeasured March, 1980

NSH

