


Labor and Materials

1	Copper	Connection	3/4	\$	96
	Lead				
1	Curb	Cock Valve T.S.&V.	3/4 in	\$	133
1	Service Box	Short 3 1/2 x 4 1/2		\$	135
	Old returned	Long 4 1/2 x 5 1/2			
		Buff on Rdway			
5	Ft.	Copper Pipe at	3/4 in 15	\$	120
	Nipples	in. at		\$	
	Bushings	to in. at		\$	
	Red's Inc's	Couplings	to in. at	\$	
	Union	in. at		\$	
	Meter	in. at		\$	
	Lbs. Br. Stone	at		\$	
	Lbs. Sand	at		\$	
	Bags Cement	at		\$	
	Paving Brick	Mack Red Asphalt at		\$	
	Lead Joints	at		\$	
	Leadite Joints	at		\$	
	Hrs. Foreman	at		\$	
	Hrs. Common Labor	at		\$	
	Hrs. Common Labor	at		\$	
	Hrs. Mason	at		\$	
	Hrs. Masons Helper	at		\$	
	Hrs. Compressor	at		\$	
	Compensation Ins			\$	
	Trucking			\$	
	Builders Use of Water			\$	
Total \$					

187 30 Labor and Material Report 9-22 1936

May 4. 20.30

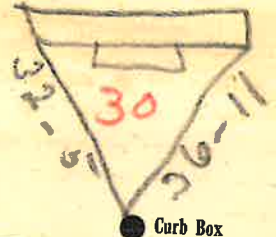

● Curb Box

4" galv. 8"-1976
Main

Elev of Main at tap

Gate at ●

● Gate at

● Curb Box

Old tap die

Tax Map # 302.20-1024

TH