


Labor and Materials

1	Copper	} Connection ^{3/4}	\$ 96
	Lead			
1	Curb	} ^{3/4} in	\$ 133
	Cock Valve T.S.&V.			
1	Service Box	} Short 3 1/2 x 4 1/2 Long 4 1/2 x 5 1/2 Buff. or Rdway	\$ 135
	Old returned			
259' 3/4	259' 3/4 Ft.	} Copper Cast Iron	Pipe at 15'	\$ 3.75
	in.			
.....	Nipples in. at	\$
.....	Bushings to in. at	\$
.....	Red'g Inc'g	} Couplings..... to in. at	\$
.....	Union.....		in. at	\$
.....	Meter.....	in. at	\$	
.....	Lbs. Br. Stone	at	\$	
.....	Lbs. Sand	at	\$	
.....	Bags Cement	at	\$	
.....	Paving Brick	} Mack Red Asphalt	at	\$
.....	Lead Joints			
.....	Leadite Joints	at	\$	
3	Hrs. Foreman	at ^{62 1/2}	\$ 1.88	
2	Hrs. Common Labor	at ⁵⁰	\$ 1.00	
6	Hrs. Common Labor	at ⁴⁵	\$ 2.70	
.....	Hrs. Mason	at	\$	
.....	Hrs. Masons Helper	at	\$	
.....	Hrs. Compressor	at	\$	
.....	Compensation Ins	\$ 1.00	
.....	Trucking	\$ 1.00	
.....	Builders Use of Water	\$	

Total \$ 17.23

Main H. 21-31

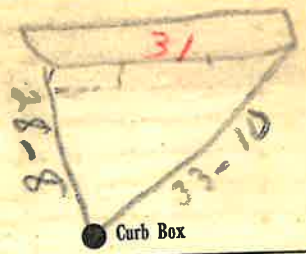

8" - 1926
Main

Elev. of Main at tap 5

Gate at ● Gate at ●

● Curb Box

Old tap Disc
Berg up at main
Tax Map # 302.20-18-2
apl. made