


LABOR AND MATERIALS

1	Copper Lead	Connection	3/4"	\$
1	Curb	Cock Valve T.S. & V.	3/4 in.	\$
1	Service box	Short 3 1/2 x 4 1/2		
	Old returned	Long 4 1/2 x 5 1/2		
		Buff or Rdway		\$
11	3/4 in. Ft.	Copper C.I. C.I.	Pipe at	\$
	Nipples	in. at		\$
	Bushings	to in. at		\$
	Red'g Inc'g	Coupl'gs to in. at		\$
	Union	in. at		\$
	Meter	in. at		\$
	Lead Joints at			\$
	Compound Joints at			\$
	Maintenance Foreman			\$
	Hrs. Water Maint. Man-1 at			\$
	Hrs. Water Maint. Man-2 at			\$
	Hrs. Garage Foreman at			\$
	Hrs. Labor— at			\$
	Hrs. Compressor at			\$
	Compensation Ins. at \$	per C.		\$
	Trucking			\$
	Pav't Patch			\$
	Tap by Gressard & Co.			\$
		6-29-56		\$
	O'head			\$

St. 5
Pl. No.
Corner May & Nelson Ave. No.

Name of Owner
For Playground.
C.D. Drinking fountain.

Labor and Mat'l. Report JUNE 29 1956

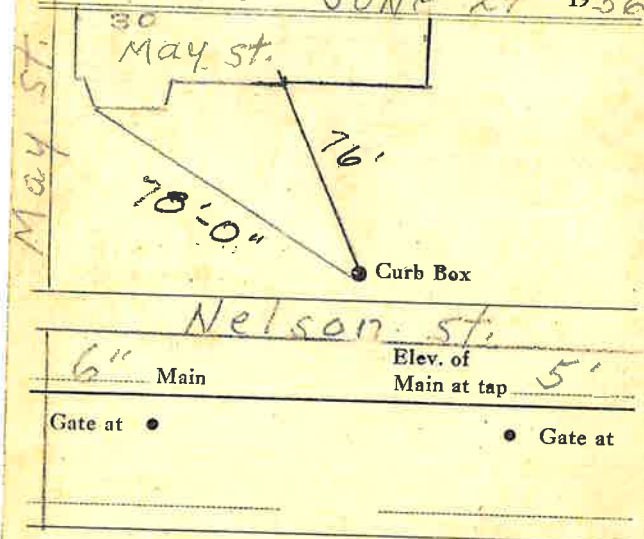

6" Main Elev. of Main at tap 5'
Gate at • Gate at •
● Curb Box
Tap on Nelson St.
Measured from East Side of 30 May St.
Remeasured 6-25-75