


Labor and Materials

1	Copper	Connection	3/4	\$	96
1	Curb	Cock Valve	3/4 in	\$	1.33
1	Service Box	Short 3 1/2 x 4 1/2		\$	1.35
	Old returned	Long 4 1/2 x 5 1/2		\$	
		Buff or Rdway		\$	
5	Ft.	Copper	3/4 in	Pipe at	15 . 135
		Cast Iron			
	Nipples	in. at		\$	
	Bushings	to in. at		\$	
	Red'g	Couplings	to in. at	\$	
	Inc'g			\$	
	Union	in. at		\$	
	Meter	in. at		\$	
	Lbs. Br. Stone	at		\$	
	Lbs. Sand	at		\$	
	Bags Cement	at		\$	
	Paving Brick	Mack		\$	
		Red		\$	
		Asphalt		\$	
	Lead Joints	at		\$	
	Leadite Joints	at		\$	
	Hrs. Foreman	at		\$	
	Hrs. Common Labor	at		\$	
	Hrs. Common Labor	at		\$	
	Hrs. Mason	at		\$	
	Hrs. Masons Helper	at		\$	
	Hrs. Compressor	at		\$	
	Compensation Ins			\$	
	Trucking			\$	
	Builders Use of Water			\$	
	Total	\$			

123 Bray St. 8
 Labor and Material Report 9-23-1976

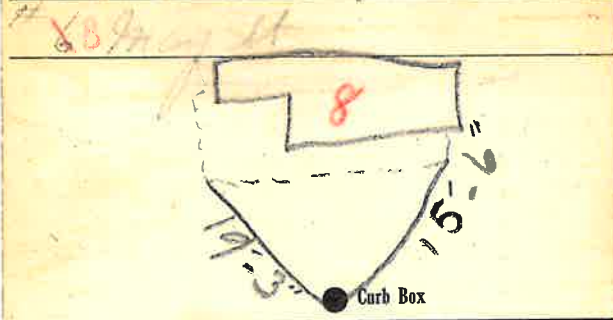

8" Galv. 1976
 # Main Elev. of Main at tap 5
 Gate at • Gate at •

● Curb Box
 Old tap Disc
 Tax Map # 302.20-9-27
 MM