


St. _____
Pl. _____
Ave. No. _____

Name of Owner
9 MAY ST

Labor and Mat'l. Report 19 _____

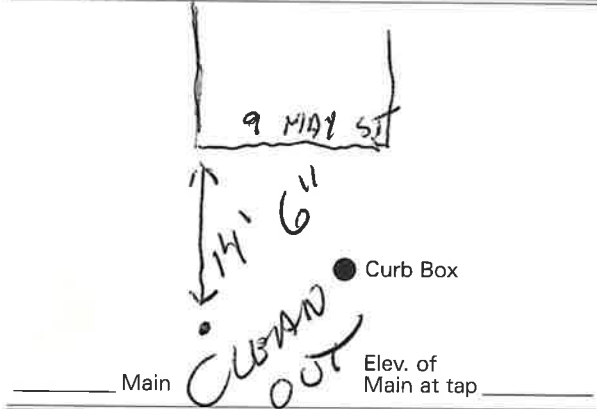

Gate at ● Gate at


● Curb Box

Tax Map # 302.20-18-11

St. _____
Pl. _____
Ave. No. 3 1/2

May
Name of Owner _____

Labor and Mat'l. Report 19 12

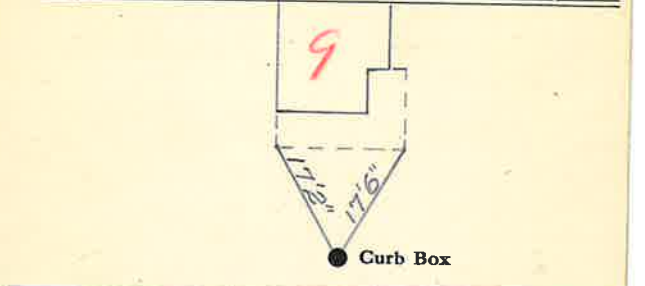

8. 1976
Main _____ Elev. of Main at tap _____

Gate at ● Gate at

● Curb Box

LABOR AND MATERIALS

_____ Copper } Connection _____ \$ _____
 _____ Lead }
 _____ Curb } Cock } _____ in. _____ \$ _____
 _____ Valve }
 _____ T.S. & V. }
 _____ Service box { Short 3-1/2 x 4-1/2 } _____ \$ _____
 _____ Old returned { Long 4-1/2 x 5-1/2 }
 _____ Ft. _____ in. { Copper } Pipe at _____ \$ _____
 _____ { G.I. }
 _____ { C.I. }
 _____ Nipples _____ in. at _____ \$ _____
 _____ Bushings _____ to _____ in. at _____ \$ _____
 _____ Red'g _____
 _____ Inc'g _____
 _____ Union _____ in. at _____ \$ _____
 _____ Meter _____ in. at _____ \$ _____
 _____ \$ _____
 _____ Compound Joints at _____ \$ _____
 _____ Maintenance Foreman _____ \$ _____
 _____ Hrs. Water Maint. Man - 1 at _____ \$ _____
 _____ Hrs. Water Maint. Man - 2 at _____ \$ _____
 _____ Hrs. Garage Foreman _____ at _____ \$ _____
 _____ Hrs. Labor _____ at _____ \$ _____
 _____ Hrs. Compressor at _____ \$ _____
 _____ \$ _____
 _____ Trucking _____ \$ _____
 _____ Pav't Patch _____ \$ _____
 _____ \$ _____
 _____ \$ _____
LABOR AND MATERIALS

1 Copper } Connection 3/4" _____ \$ _____
 _____ Lead }
 1 Curb { Cock } 3/4" in. _____ \$ _____
 _____ Valve }
 _____ T.S. & V. }
 1 Service Box { Short 3 1/2 x 4 1/2 } ? _____ \$ _____
 _____ Old returned { Long 4 1/2 x 5 1/2 }
 _____ { Buff. or Rdway }
 23 Ft. 3/4 in. { Copper } Pipe at _____ \$ _____
 _____ { Galvanized }
 _____ { Cast Iron }
 _____ Nipples _____ in. at _____ \$ _____
 _____ Bushings _____ to _____ in. at _____ \$ _____
 _____ Red'g } Couplings _____ to _____ in. at _____ \$ _____
 _____ Inc'g }
 _____ Union _____ in. at _____ \$ _____
 _____ Meter _____ in. at _____ \$ _____
 _____ Lead Joints at _____ \$ _____
 _____ Leadite Joints at _____ \$ _____
 _____ Hrs. Foreman at _____ \$ _____
 _____ Hrs. Chauffeur at _____ \$ _____
 _____ Hrs. Tapper at _____ \$ _____
 _____ Hrs. Labor at _____ \$ _____
 _____ Hrs. Labor at _____ \$ _____
 _____ Hrs. Compressor at _____ \$ _____
 _____ Compensation Ins. _____ \$ _____
 _____ Trucking _____ \$ _____
 _____ Builders Use of Water _____ \$ _____
 _____ \$ _____
 _____ \$ _____
