

### Labor and Materials


Lead	Copper } Connection.....	3	\$1.33
Lead	Curb { Cock Valve } .....	3	\$1.58
Lead	Service Box { Short 3 1/2 x 4 1/2 } .....		\$1.36
Lead	Old returned { Long 4 1/2 x 6 1/2 } .....		
8 Ft.	3/4 in. { Copper } Pipe at .....		.76
	{ Galv. Iron } .....		
	{ Cast Iron } .....		
	Nipples .....	in. at .....	\$ .....
	Bushings .....	to .....	in. at .....
	Red'g } Couplings .....	to .....	in. at .....
	Inc'g }		
	Union .....	in. at .....	\$ .....
	Meter .....	in. at .....	\$ .....
	Lbs. Br. Stone at .....		\$ .....
	Lbs. Sand at .....		\$ .....
	Bags Cement at .....		\$ .....
	Paving Brick { Mack } at .....		\$ .....
	{ Red } .....		\$ .....
	{ Asphalt } .....		\$ .....
	Lead Joints at .....		\$ .....
	Leadite Joints at .....		\$ .....
8	Hrs. Foreman at .....		\$5.00
17	Hrs. Common Labor at .....		\$5.40
	Hrs. Common Labor at .....		\$ .....
	Hrs. Mason at .....		\$ .....
	Hrs. Masons Helper at .....		\$ .....
	Hrs. Compressor at .....		\$ .....
	Compensation Ins .....		\$32
	Trucking .....		\$5
	Builders Use of Water <i>Patak</i> .....		\$5
Total			\$21.75

33-78

Labor and Material Report

17 Oct 19 1933

13 McDonald St

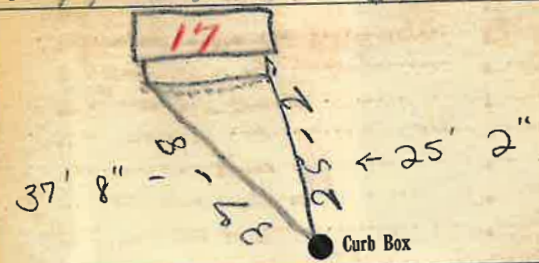

8" 1975

Main

Elev. of Main at tap

Gate at ●

● Gate at

● Curb Box

*old Tap shut off at Main*

TAX ID # 303.18-12-10

*[Handwritten signature]*