

LABOR AND MATERIALS

1. Copper	}	Connection	3/4	\$	2.94
Lead					
1. Curb	}	Cock	3/4 in.	\$	3.71
Valve					
T. S. & V.					
1. Service box	}	Short	3 1/2 X 4 1/2	\$	5.90
Old returned		Long	4 1/2 X 5 1/2		
		Buff or Rdway			
8. Ft.	3/4	Copper	Pipe at	30	\$ 2.40
		G. I.			
		C. I.			
Nipples	in. at			\$	
Bushings	to	in. at		\$	
Red'g					
Inc'g	Coupl'gs	to	in. at	\$	
Union	in. at			\$	
Meter	in. at			\$	
Lead Joints	at			\$	
Compound Joints	at			\$	
5. Hrs. Water Maint. Man-1	at	1.01	\$	5.05	
Hrs. Water Maint. Man-2	at		\$		
6. Hrs. Labor	at	80	\$	4.80	
Hrs. Labor	at		\$		
Hrs. Compressor	at		\$		
Compensation Ins.	at \$	per C.	\$	2.2	
Trucking			\$	1.00	
Pav't Patch			\$	13.30	
1 sig. by Miller					
O'head			\$		
				\$	39.32

42

St.

Pl.

Ave. No.

McDonald


25

Name of Owner

D & H Railroad

Labor and Mat'l. Report

May 18 1948

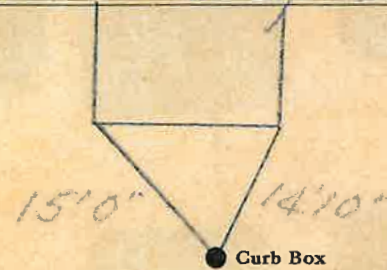

8-1975

X Main

Elev. of

Main at tap

5

Gate at ●

● Gate at

#25 - #27 TAX ID # 303.18-6-20

● Curb Box

Curb box bent over
+ removed. 1971

Shut off at Curb-10-4-61