

LSM-8C-3-10-61

#29  
McDonald

22'-2"      28'

● Curb Box

---

● Gate at      ● Gate at

---

Elev. of Main at tap      Main

5 1/4"      8"-1975

---

● Curb Box

Try 20' 7"      Try 32' 9"      21' 9"      27' 8"

#29

See Below

---

Labor and Mat'l. Report      Mar, 29 19 62.

---

Name of Owner      Toomey

---

St.      Pt.      Ave. No. 29

McDonald

St.      Pt.      Ave. No. 29

McDonald

Name of Owner      Toomey

---

Labor and Mat'l. Report      Mar, 29 19 62.

---

#29

See Below

21' 9"      27' 8"      20' 7"      32' 9"

● Curb Box

---

Elev. of Main at tap      5 1/4"

Main

---

● Gate at      ● Gate at

---

● Curb Box

22'-2"      28'

#29  
McDonald

LSM-8C-3-10-61

TAX ID # 303.18-6-19


LABOR AND MATERIALS

1	Copper	Connection	3/4"	\$	
1	Lead	Cock		\$	
1	Curb	Valve	3/4" in.	\$	
		T.S. & V.			
1	Service box	Short 3 1/2 x 4 1/2		\$	
	Old returned	Long 4 1/2 x 5 1/2			
		Buff or Rdway		\$	
8	Ft.	Copper	3/4" in.	Pipe at	\$
		G.I.			
		C.I.			
	Nipples	in. at		\$	
	Bushings	to in. at		\$	
	Red'g				
	Inc'g	Coupl'gs to in. at		\$	
	Union	in. at		\$	
	Meter	in. at		\$	
	Lead Joints	at		\$	
	Compound Joints	at		\$	
	Maintenance Foreman			\$	
	Hrs. Water Maint. Man-1	at		\$	
	Hrs. Water Maint. Man-2	at		\$	
	Hrs. Garage Foreman	at		\$	
	Hrs. Labor	at		\$	
	Hrs. Compressor	at		\$	
	Compensation Ins. at \$	per C		\$	
	Trucking			\$	
	Pav't Patch			\$	
	Tap by G. S. GORD			\$	
	+ Co. 3-29-62			\$	
	O'head			\$	

McDonald St. Pl. Ave. No. 29

Name of Owner

Labor and Mat'l. Report 19

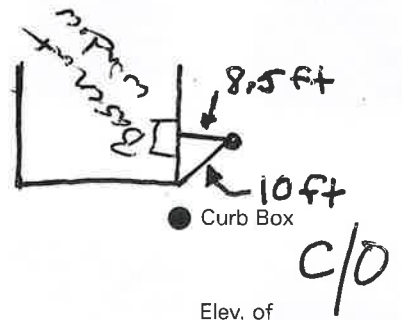

Main Elev. of Main at tap

Gate at Gate at

Curb Box