


LABOR AND MATERIALS

| | | | | |
|------|----------------------------|--|--------------|----------|
| 1 | Copper Lead | Connection | 3/4 | \$ 2.29 |
| 1 | Curb | Cock Valve T.S. & V. | 3/4 in. | \$ 2.70 |
| 1 | Service box Old returned | Short 3 1/2 x 4 1/2 Long 4 1/2 x 5 1/2 Buff or Rdway | | \$ 4.25 |
| 8/10 | Ft. 3/4 in. | Copper G.I. Pipe at | 35 | \$ 2.80 |
| | Nipples | in. at | | \$ |
| | Bushings | to in. at | | \$ |
| 1 | Red'g Inc'g | Coupl'gs 3/4 to 3/4 in. at | Cop. to COP. | \$ |
| | Union | in. at | | \$ |
| | Meter | in. at | | \$ |
| | Lead Joints at | | | \$ |
| | Compound Joints at | | | \$ |
| | Hrs. Water Maint. Man-1 at | | | \$ |
| 13 | Hrs. Water Maint. Man-2 at | 1.02 | | \$ 13.26 |
| 15 | Hrs. Labor— at | 91 | | \$ 13.65 |
| | Hrs. Labor— at | | | \$ |
| 2 | Hrs. Compressor at | 1.20 | | \$ 2.40 |
| | Compensation Ins. at \$ | per C. | | \$ 60 |
| | Trucking | | | \$ 1- |
| | Pav't Patch | | | \$ 10.80 |
| | 1044 McG... | | | \$ |
| | O'head | | | \$ |
| | | | | \$ 53.75 |

St. Pl. Ave. No. 7
 McDonald

Name of Owner
 Harens & Sullivan

Labor and Mat'l. Report June 6 1950

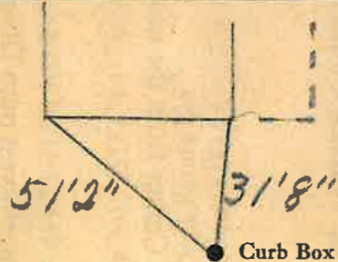

8''-1958
 4'' Main

Elev. of Main at tap 6

Gate at ● Gate at ●

TAX ID # 303.18-12-15

● Curb Box