


LABOR AND MATERIALS

1	Copper	} Connection <u>3/4"</u>	\$
1	Lead		\$
1	Curb	} Cock Valve T.S. & V. } <u>3/4 in.</u>	\$
1	Service box		\$
	Old returned	{ Short <u>3 1/2 x 4 1/2</u> Long <u>4 1/2 x 5 1/2</u> Buff or Rdway }	\$
8	Ft. <u>3/4 in.</u>	{ Copper } Pipe at	\$
		{ G. I. }	\$
		{ C. I. }	\$
	Nipples	in. at	\$
	Bushings	to in. at	\$
	Red'g	} Coupl'gs to in. at	\$
	Inc'g		\$
	Union	in. at	\$
	Meter	in. at	\$
	Lead Joints	at	\$
	Compound Joints	at	\$
	Maintenance Foreman		\$
	Hrs. Water Maint. Man-1	at	\$
	Hrs. Water Maint. Man-2	at	\$
	Hrs. Garage Foreman	at	\$
	Hrs. Labor	at	\$
	Hrs. Compressor	at	\$
	Compensation Ins. at \$	per C	\$
	Trucking		\$
	Pav't Patch		\$
	<u>Tap by Gifford &amp; Co.</u>		
	<u>3-26-62</u>		
	O'head		\$

McDonald St. Pl  
Ave. No. 31

Name of Owner

Labor and Mat'l. Report Mar. 26 1962

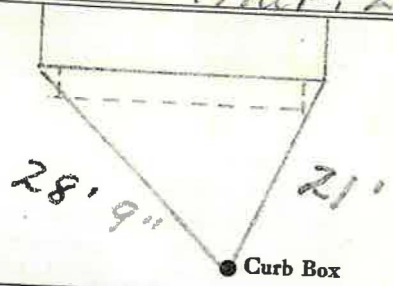

8"-1975  
1/4" Main

Elev. of Main at tap 5' 1/2"

Gate at ●

● Gate at

● Curb Box

TAX ID # 303.18-6-18