


LABOR AND MATERIALS

1	Copper	} Connection	3/4"	\$	
	Lead				
1	Curb	} Cock	3/4 in.	\$	
					} Valve
1	Service box	} { Short 3 1/2 x 4 1/2		\$	
	Old returned				} Long 4 1/2 x 5 1/2
8	Ft. 3/4 in.	} { Copper	} Pipe at	\$	
					} G.I.
	Nipples	in. at	\$		
	Bushings	to in. at	\$		
	Red'g	} Coupl'gs	to in. at	\$	
	Inc'g				
	Union	in. at	\$		
	Meter	in. at	\$		
	Lead Joints	at	\$		
	Compound Joints	at	\$		
	Maintenance Foreman		\$		
	Hrs. Water Maint. Man-1	at	\$		
	Hrs. Water Maint. Man-2	at	\$		
	Hrs. Garage Foreman	at	\$		
	Hrs. Labor	at	\$		
	Hrs. Compressor	at	\$		
	Compensation Ins. at \$	per C	\$		
	Trucking		\$		
	Pav't Patch		\$		
	Tap by SEYMOUR		\$ Co.		
	8 - 23 - 11		\$		
	O'head		\$		

St. McDonald Ave. No. 37
 -PT-

Name of Owner
 Floyd Belstraz

Labor and Mat'l. Report Aug 23 1971

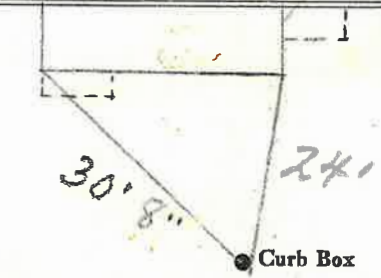

8"-1975
 22" Main Elev. of Main at tap 5'

Gate at • Gate at •

TAX ID # 303.18-6-15

• Curb Box