


LABOR AND MATERIALS

1 Copper } Connection 3/4" \$  
 Lead }  
 1 Curb } Cock } 3/4 in. (HAYES COP) \$  
 Valve }  
 T.S. & V. }  
 1 Service box } { Short 3 1/2 x 4 1/2 } \$  
 Old returned } { Long 4 1/2 x 5 1/2 }  
 Buffer or Rdway }  
30 Ft. 3/4 in. } { Copper } Pipe at \$  
 } { G. I. }  
 } { C. I. }  
 Nipples in. at \$  
 Bushings to in. at \$  
 Red'g }  
 Inc'g } Coupl'gs to in. at \$  
 Union in. at \$  
 Meter in. at \$  
 Lead Joints at \$  
 Compound Joints at \$  
 Maintenance Foreman \$  
 Hrs. Water Maint. Man-1 at \$  
 Hrs. Water Maint. Man-2 at \$  
 Hrs. Garage Foreman at \$  
 Hrs. Labor at \$  
 Hrs. Compressor at \$  
 Compensation Ins. at \$ per C \$  
 Trucking \$  
 Pav't Patch \$  
TAP MADE BY BEECHER \$  
& CO. \$  
 O'head Sept. 21-1973 \$

St. Mc DONALD  
 Ave. No. 38

Name of Owner DENNIS CORBET

Labor and Mat'l. Report Sept 21 1973

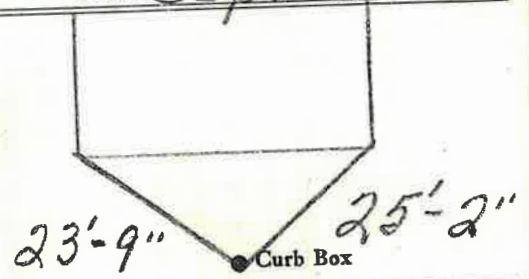

4" Main Elev. of Main at tap 5'  
 Gate at • Gate at •

TAX ID # 303.18-5-4

• Curb Box

OK