

LABOR AND MATERIALS

Copper } Connection		\$	
Lead } Cock			
Curb } Valve	in.	\$	
	T. S. & V.		
Service box } Short 3 1/2 x 4 1/2			
Old returned } Long 4 1/2 x 5 1/2		\$	
12 Ft. 3/4 in. } Copper	} Pipe at	\$	
			G. I.
			G. I.
Nipples	in. at	\$	
Bushings	to in. at	\$	
Red'g } Coupl'gs	to in. at	\$	
Inc'g }			
Union	in. at	\$	
Meter	in. at	\$	
		\$	
Compound Joints	at	\$	
Maintenance Foreman		\$	
Hrs. Water Maint. Man-1	at	\$	
Hrs. Water Maint. Man-2	at	\$	
Hrs. Garage Foreman	at	\$	
Hrs. Labor	at	\$	
Hrs. Compressor	at	\$	
		\$	
Trucking		\$	
Pav't Patch		\$	
		\$	
		\$	

McDonald

St.
 Pl.
 Ave. No. 45

Name of Owner

Labor and Mat'l. Report

1988

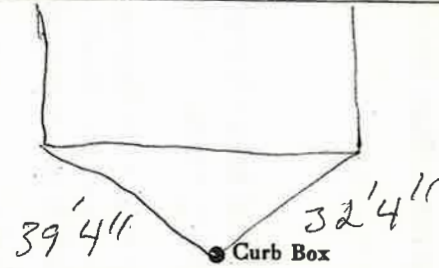

Main Elev. of
Main at tap

Gate at ● ● Gate at

TAX ID # 303.18-6-12

● Curb Box