

LABOR AND MATERIALS

| | | | |
|-------|-----------------------------|--|----------|
| 1 | Copper Lead | Connection $\frac{3}{4}$ " | \$ 2.76 |
| 1 | Curb | Cock Valve T. S. & V. $\frac{3}{4}$ in. | \$ 3.49 |
| 1 | Service box Old returned | Short $3\frac{1}{2}$ X $4\frac{1}{2}$ Long $4\frac{1}{2}$ X $5\frac{1}{2}$ Buff or Rdway | \$ 4.74 |
| 10 | Ft. $\frac{3}{4}$ " in. | Copper C.I. C.I. Pipe at 38 | \$ 3.90 |
| | Nipples | in. at | \$ |
| | Bushings | to in. at | \$ |
| | Red'g Inc'g | Coupl'gs..... to in. at | \$ |
| | Union | in. at | \$ |
| | Meter | in. at | \$ |
| | Lead Joints | at | \$ |
| | Compound Joints | at | \$ |
| | Hrs. Water Maint. Man | —1 at | \$ |
| 9 | Hrs. Water Maint. Man | —2 at 1.24 | \$ 1.16 |
| 29 | Hrs. Labor | at 1.13 | \$ 32.77 |
| | Hrs. Labor | at | \$ |
| | Hrs. Compressor | at | \$ |
| | Compensation Ins. | at \$4.06 per C | \$ 1.94 |
| | Trucking | | \$ 1.00 |
| | Pav't Patch | | \$ 12.60 |
| | Tap by Gifford | | \$ |
| | Feb 24-53 | | \$ |
| | O'head | | \$ |
| | | | \$ 74.26 |

61.66


43.98

16-53

St.
Pl. Ave. No. 55

McDonald
Name of Owner Bellephine
Bettifemini

Labor and Mat'l. Report Feb 25 1953

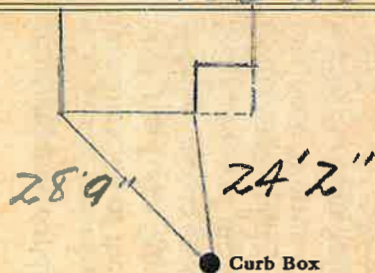

8"-1975
4" Main

Elev. of Main at tap 4 1/2'

Gate at ● Gate at ●

TAX ID # 303.18-1-9

● Curb Box