

LABOR AND MATERIALS


1 Copper Lead	{ Connection $\frac{3}{4}$ in.	\$ 1.23
1 Curb	{ Cock Valve T.S. & V. } $\frac{3}{4}$ in.	\$ 1.65
1 Service Box Old returned	{ Short $3\frac{1}{2} \times 4\frac{1}{2}$ Long $4\frac{1}{2} \times 5\frac{1}{2}$ Buff. or Rdway }	\$ 1.54
9 Ft. $\frac{3}{4}$ in.	{ Copper Galv Iron Cast Iron } Pipe at	\$ 1.53
Nipples	in. at	\$
Bushings	to in. at	\$
Red'g Inc'g	{ Couplings to in. at	\$
Union	in. at	\$
Meter	in. at	\$
Lead Joints at		\$
Leadite Joints at		\$
Hrs. Foreman at		\$
4 Hrs. Chauffeur at	62 1/2	\$ 2.50
6 Hrs. Tapper at		\$ 3.75
6 Hrs. Labor at	45	\$ 2.70
Hrs. Labor at		\$
1 Hrs. Compressor at	65	\$.65
Compensation Ins.		\$ 28
Trucking		\$ 1-
Builders Use of Water		\$
Taphy Hessel		\$
Pitch		\$ 5.00
		\$
		\$ 21.86

14 - 1939

St. 57
 Pt. 39
 Ave. No. 39

McDonald
 Name of Owner
 Geo Casey

Labor and Mat'l. Report Apr 29 1939

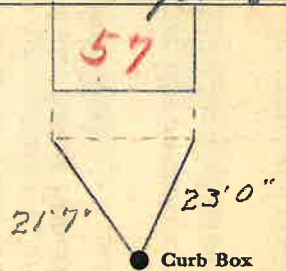

8-1915
 Main

Elev. of Main at tap 9 1/2

Gate at ● Gate at ●

TAX ID # 303.18-1-8

● Curb Box

old street off to be changed.