

LABOR AND MATERIALS


1	Copper Lead	Connection	3/4"	\$
1	Curb	Cock Valve T.S. & V.	3/4 in.	\$
1	Service box	Short 3 1/2 x 4 1/2		
	Old returned	Long 4 1/2 x 5 1/2		
		Buff or Rdway		\$
9	Ft.	Copper G.I. C.I.	3/4 in. Pipe at	\$
	Nipples	in. at		\$
	Bushings	to in. at		\$
	Red'g Inc'g	Coupl'gs to in. at		\$
	Union	in. at		\$
	Meter	in. at		\$
	Lead Joints	at		\$
	Compound Joints	at		\$
	Maintenance Foreman			\$
	Hrs. Water Maint. Man-1	at		\$
	Hrs. Water Maint. Man-2	at		\$
	Hrs. Garage Foreman	at		\$
	Hrs. Labor	at		\$
	Hrs. Compressor	at		\$
	Compensation Ins.	at \$ per C		\$
	Trucking			\$
	Pav't Patch			\$
	Tap by Hareau & Co.			\$
	9-29-59.			\$
	O'head			\$

✓

McDonald St. Pl. Ave. No. 59


Name of Owner Mrs. A. C. Deligan.

Labor and Mat'l. Report Sept. 29 19 59

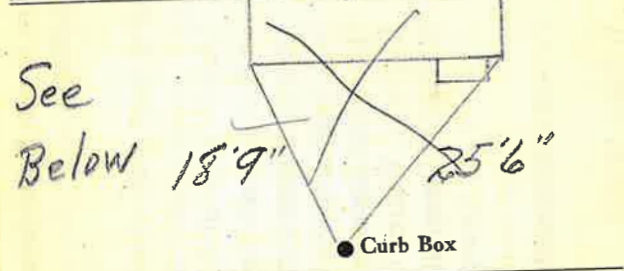

8"-1975
Main Elev. of Main at tap 4'
Gate at • Gate at •

TAX ID # 303.18-1-7

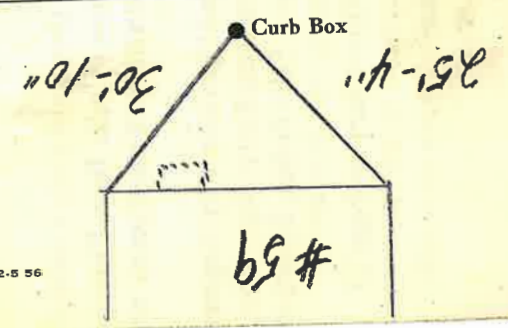


LSM-5C-2-5 56

59

30'-10" 4'-15" Curb Box

Gate at • Gate at •

Elev. of Main at tap 4' 8"-1975

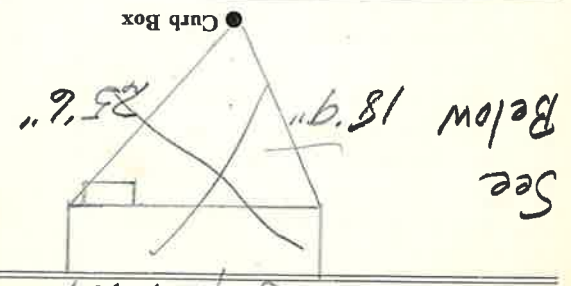

See

Labor and Mat'l. Report Sept. 29 19 59

Name of Owner Mrs. H.C. Deligan.

St. McDonald Ave. No. 59

✓