


### Labor and Materials

1	Copper } Connection		\$ 3.20
1	Lead } Cock		
1	Curb } Valve	3/4 in.	\$ 1.00
		P.S. & V.	
1	Service Box } Short 3 1/2 x 4 1/2		
	Old returned } Long 4 1/2 x 5 1/2		\$ 1.30
		Buff. or Rdway	
32	Ft. 3/4 in. } Copper		
		Galv. Iron	\$ 7.04
		Cast Iron	
	Nipples	in. at	\$
1	Bushings	1/2 to 3/4 in. at	\$ .08
	Red'g } Couplings	to in. at	\$
	Inc'g }		
	Union	in. at	\$
	Meter	in. at	\$
	Lbs Br. Stone at		\$
	Lbs. Sand at		\$
	Bags Cement at		\$
	Paving Brick } Mack		
		Red	\$
		Asphalt	\$
	Lead Joints at		\$
	Leadite Joints at		\$
3	Hrs. Foreman at	6.25	\$ 1.87
1.7	Hrs. Common Labor at	5.0	\$ 8.50
1.6	Hrs. Common Labor at	4.05	\$ 6.50
	Hrs. Mason at		\$
	Hrs Mason's Helper at		\$
	Hrs. Compressor at		\$
	Compensation Ins.		\$ 44
	Trucking		\$ 1.00
	Builders' Use of Water		\$
Total			\$ 30.93

### Labor and Material Report

19 26

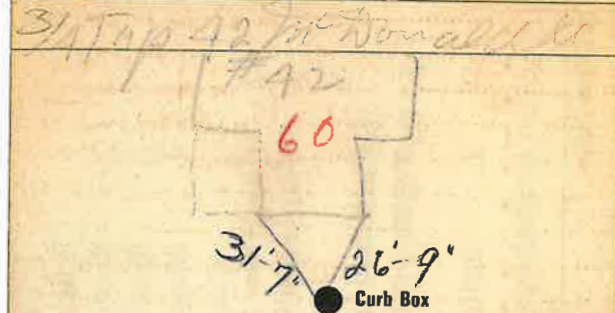

8"-1975

Main

Elev. of Main at tap 35

Gate at ●

● Gate at

● Curb Box

TAX ID # 303.17-7-1