

LABOR AND MATERIALS

1	Copper Lead	} Connection	3/4		\$ 1.35
1	Curb	{ Cock Valve T.S. & V.	{ 3/4	in.	\$ 1.80
1	Service Box Old returned	{ Short 3 1/2 x 4 1/2 Long 4 1/2 x 5 1/2 Buffer Rdway			\$ 1.70
10	Et.	{ Copper Galv. Iron Cast Iron	{ 3/4	in. Pipe at	\$ 1.80
	Nipples	in. at			
	Bushings	to in. at			
1	Red'g Inc'g	} Couplings	3/4 to 3/4	in. at	\$ Cop.
	Union	in. at			
	Meter	in. at			
	Lead Joints	at			
	Leadite Joints	at			
	Hrs. Foreman	at			
2	Hrs. Chauffeur	at	6 1/2		\$ 12.5
7	Hrs. Tapper	at	7		\$ 4.38
8	Hrs. Labor	at	45		\$ 2.70
	Hrs. Labor	at			
1	Hrs. Compressor	at	6 1/2		\$.63
	Compensation Ins.				\$.26
	Trucking				\$ 1.00
	Builders Use of Water	Patch			\$ 5.00
					\$
					\$
					\$ 21.87

8 3 1941

St. 9
PT
Ave. No. 5


Name of Owner

Tooney

Labor and Mat'l. Report

Aug 20

1941

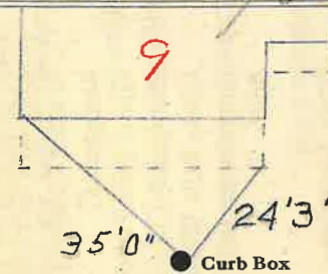

8" - 1958

4" Main

Elev. of
Main at tap 5 1/2

Gate at ●

● Gate at

TAX ID # 303.18-12-14

● Curb Box