


Labor and Materials

1	Copper } Connection	3/4	\$	96
1	Lead } Connection	3/4	\$	96
1	Curb { Cock Valve T.S.&V. }	3/4	in	\$ 1.33
1	Service Box { Short 3 1/2 x 4 1/2 Long 4 1/2 x 5 1/2 } Old returned { Built on Rwy. }			\$ 1.35
8	3/4 in. { Copper Galv. Iron Cast Iron } Pipe at	15		\$	1.20
	Nipples		in. at	\$	
	Bushings		to .. in. at	\$	
	Red'g Inc'g } Couplings		to .. in. at	\$	
	Union		in. at	\$	
	Meter		in. at	\$	
	Lbs. Br. Stone		at	\$	
	Lbs. Sand		at	\$	
	Bags Cement		at	\$	
	Paving Brick { Mack Red Asphalt }		at	\$	
	Lead Joints		at	\$	
	Leadite Joints		at	\$	
5	Hrs. Foreman	6 1/2		\$	3.13
9	Hrs. Common Labor	50		\$	4.50
6	Hrs. Common Labor	45		\$	2.70
	Hrs. Mason		at	\$	
	Hrs. Masons Helper		at	\$	
	Hrs. Compressor		at	\$	
	Compensation Ins			\$	3.2
	Trucking			\$	1.00
	Builders Use of Water	Patch		\$	5.00

Total \$ 21.49

71
51 McDonald St

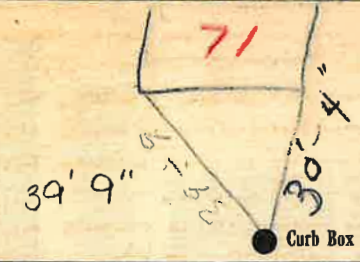

8" 1915
Main

Elev of Main at tap 6

Gate at ●

● Gate at

● Curb Box

New House

TAX ID # 303.14-2-24