

LABOR AND MATERIALS

Copper	} Connection	_____	\$ _____
Lead			
Curb	} Cock Valve T. S. & V.	_____ in.	\$ _____
Service box	} Short 3½ x 4½ } Long 4½ x 5½ }	_____	\$ _____
Old returned			
28'6" Ft.	} Copper } } G.I. } } C.I. }	3/4 in. Pipe at	\$ _____
Nipples	_____ in. at	\$ _____	
Bushings	_____ to _____ in. at	\$ _____	
Red'g } Inc'g }	Coupl'gs _____ to _____ in. at	\$ _____	
Union	_____ in. at	\$ _____	
Meter	_____ in. at	\$ _____	
		\$ _____	
Compound Joints	at	\$ _____	
Maintenance Foreman		\$ _____	
Hrs. Water Maint. Man-1	at	\$ _____	
Hrs. Water Maint. Man-2	at	\$ _____	
Hrs. Garage Foreman	at	\$ _____	
Hrs. Labor	_____ at	\$ _____	
Hrs. Compressor	at	\$ _____	
		\$ _____	
Trucking		\$ _____	
Pav't Patch		\$ _____	
		\$ _____	
		\$ _____	
		\$ _____	
		\$ _____	

Mc DONALD


St. _____
Pl. _____
Ave. No. 72

Name of Owner

ABRAHAM WING SCHOOL

Labor and Mat'l. Report

1995

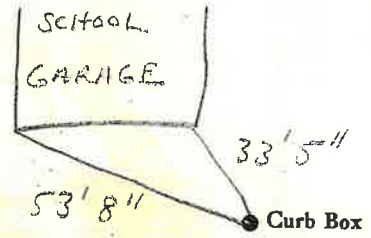

_____ Main	Elev. of Main at tap _____
Gate at ●	● Gate at
_____	_____

● Curb Box